
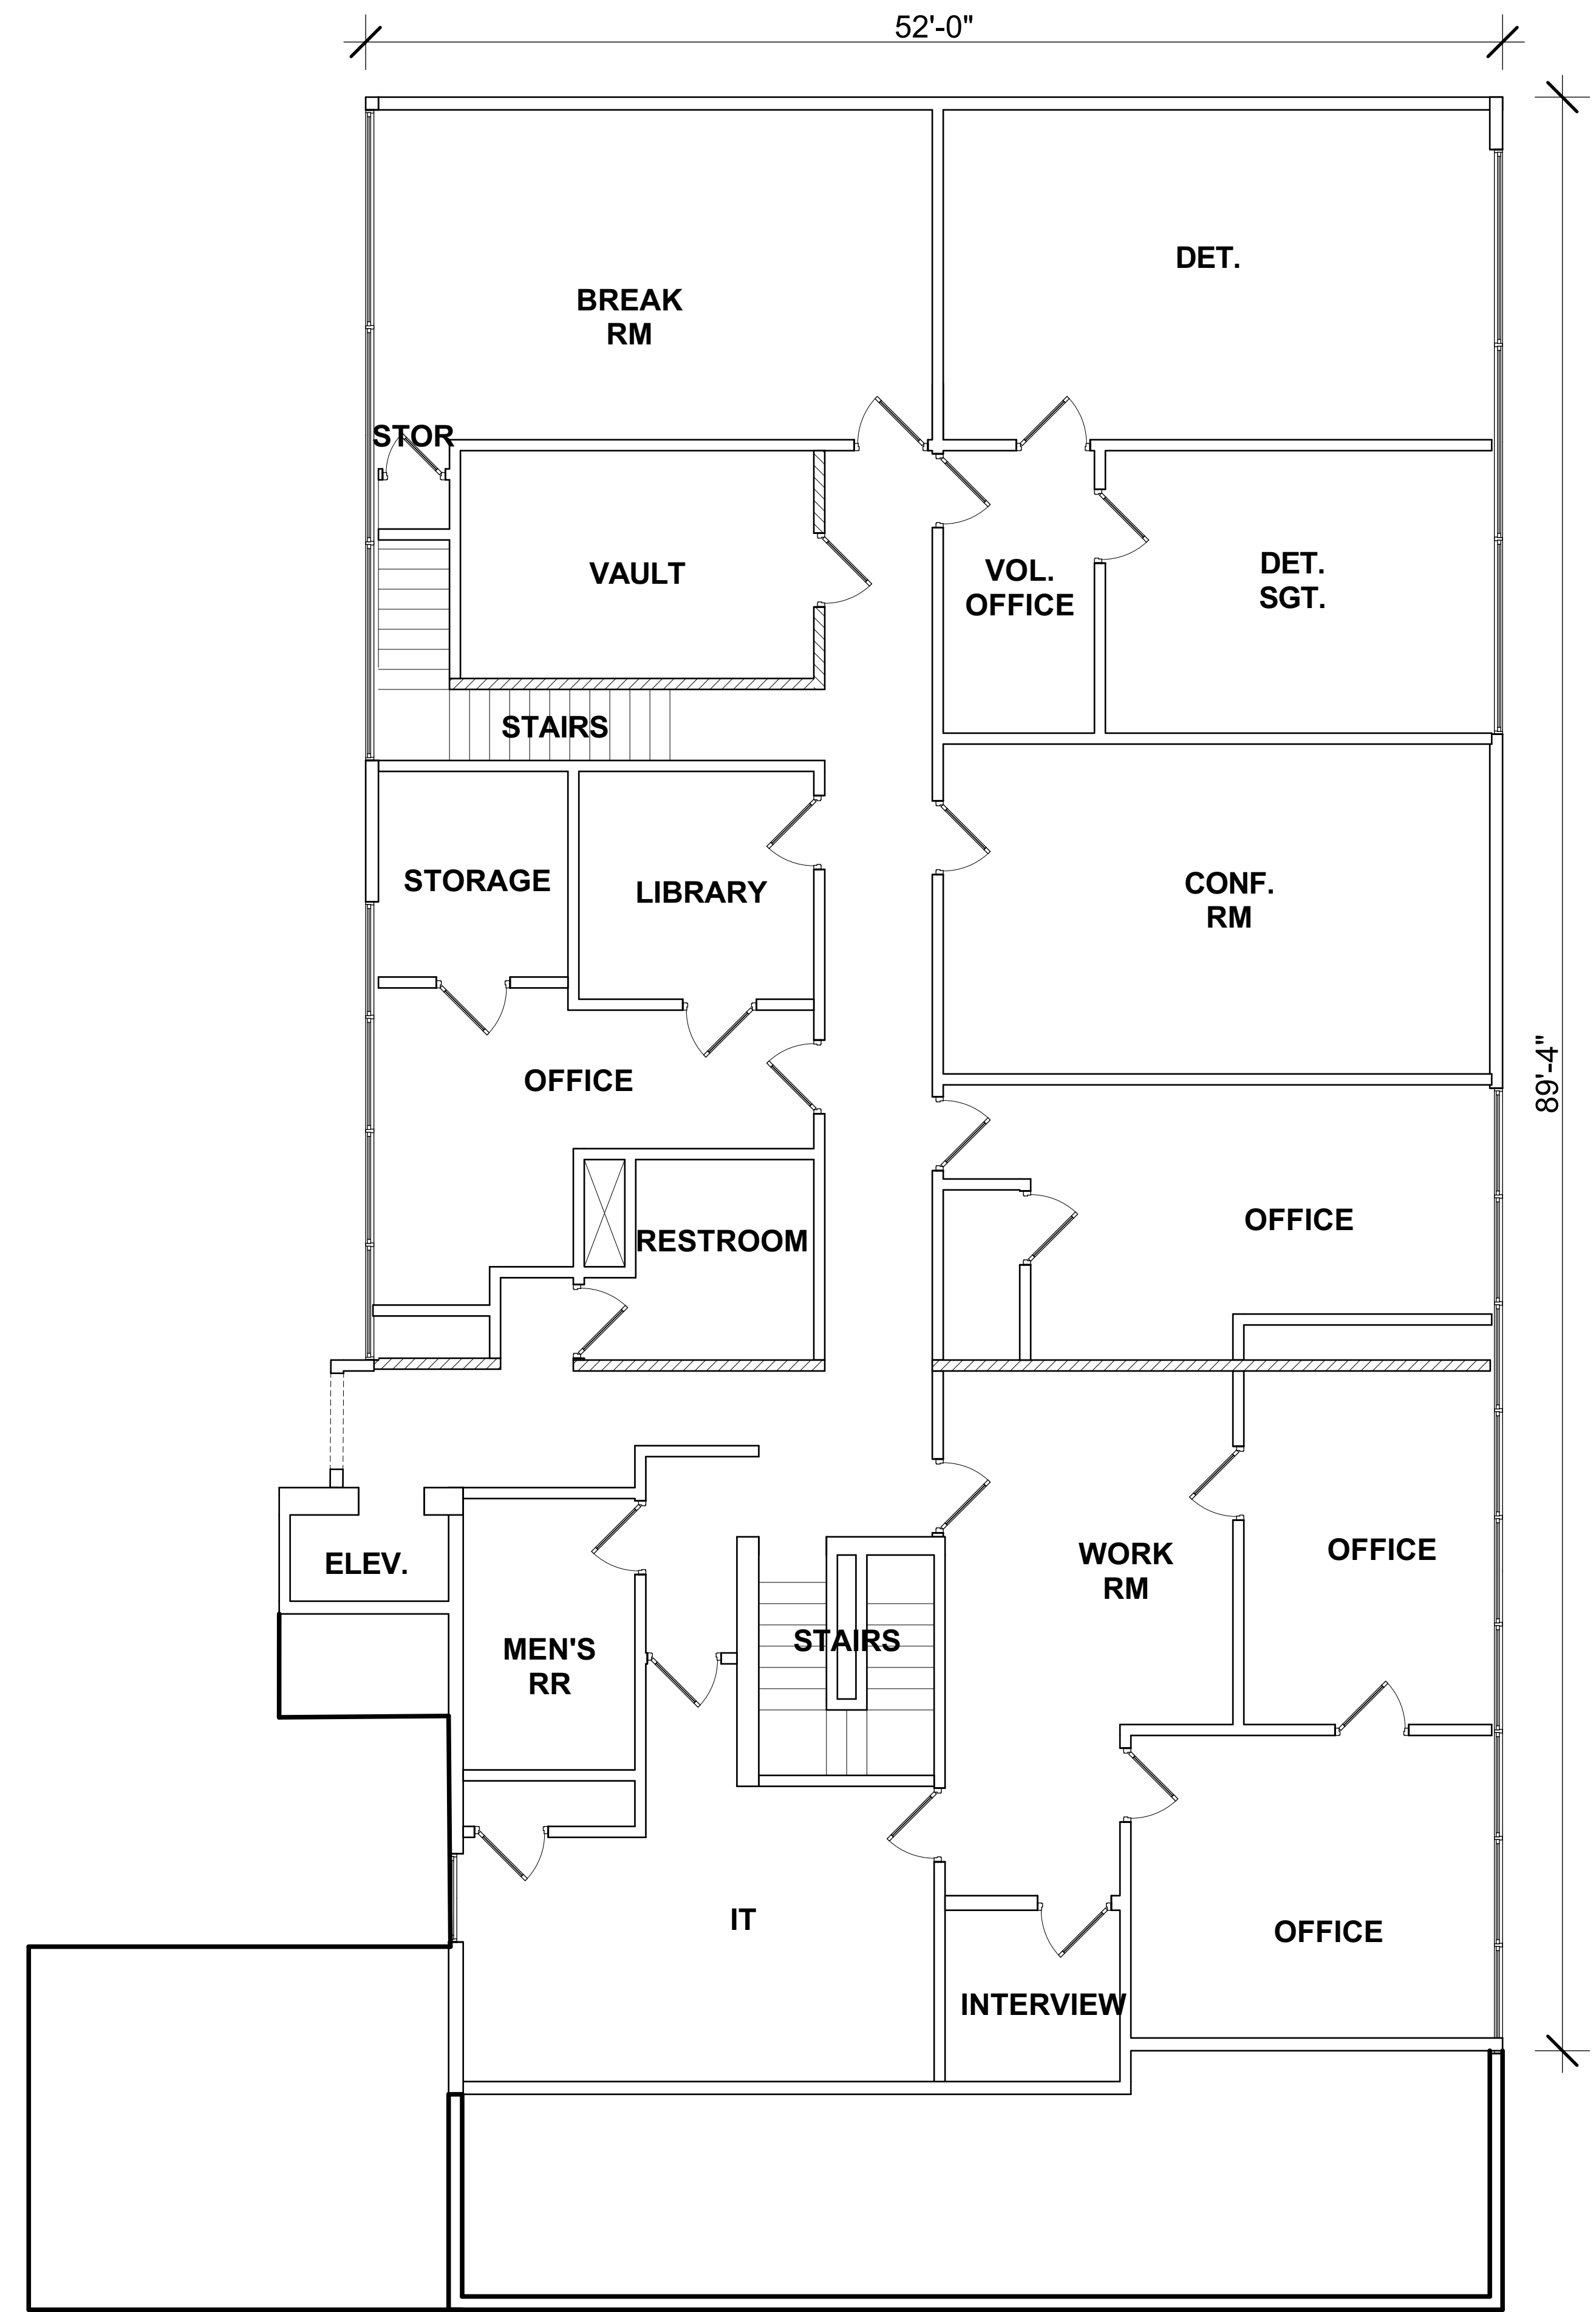


**POLICE ANNEX DEMO 1ST FLOOR PLAN**

SCALE: 3/16" = 1'-0"

AREA: 4,985 SQ. FT.

PLAN NORTH

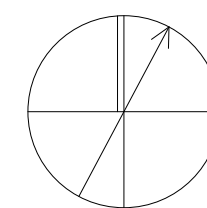


**POLICE ANNEX DEMO 2ND FLOOR PLAN**

SCALE: 3/16" = 1'-0"

AREA: 5,215 SQ. FT.

PLAN NORTH

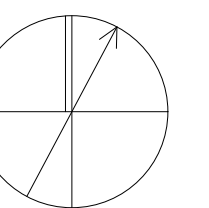

**LOS BANOS CIVIC CENTER MASTER PLAN**

INDIGO | HAMMOND + PLAYLE ARCHITECTS

**DRAFT**