



City of Los Banos

At the Crossroads of California

ADDENDUM NO. 1

May 22, 2024

Community Center Perimeter Fence Project No. 24-CC-0001

The purpose of this addendum is to officially respond to questions as they relate to the Community Center Perimeter Fence Project.

1. **Question:** The Plans call for 6' chain link fence and gates; bid items and the last page of the project manual call for flat top tan iron fence and gates. If is to be iron, can you please provide more detail on post, rail and picket size?

Response: Please see Exhibit A for updated plans. This can also be found using the following link:

The detail information requested is as follows:

- 1-1/2 x 1-1/2 rails, 3/4 pickets, 2-1/2 x 2-1/2 11gauge posts
- Posts are to be set 2 feet down in concrete

This Addendum forms a part of the Proposal Documents and will be incorporated into the Contract Documents, as applicable. All other conditions of the Contract Documents remain unchanged. The following changes, additions, or deletions as set forth herein shall apply to the Contract Documents and shall be made a part thereof and shall be subject to all the requirements thereof as through originally shown and/or specified.

Proposals shall be submitted in accordance with this Addendum. All consultants **MUST** acknowledge receipt of this Addendum by signing and returning this Addendum with your Proposal.

City of Los Banos

By: Joe Heim
Parks and Recreation Director

Firm Name: _____

By: _____

Title: _____



Date: _____

LEGEND

	ELECTRICAL PULL BOX
	ELECTRICAL VAULT
	ELECTRICAL TRANSFORMER
	CABLE PULL BOX
	CABLE RISER
	TELEPHONE MANHOLE
	ELECTRICAL MANHOLE
	TRAFFIC SIGNAL PULL BOX
	TRAFFIC SIGNAL
	STREET LIGHT
	AREA LIGHT
	PEDESTRIAN PATH LIGHT
	EXISTING SITE LIGHT
	WATER METER
	WATER HYDRANT
	WATER VALVE
	FIRE DEPARTMENT CONNECTION
	BACKFLOW PREVENTOR
	WATER DETECTOR CHECK
	IRRIGATION PULLBOX
	SEWER MANHOLE
	SEWER CLEANOUT
	STORM DRAIN INLET
	STORM DRAIN GRATE
	STORM DRAIN MANHOLE
	SIGN
	BOLLARD
	CHAINLINK FENCE
	CURB AND GUTTER
	EXISTING TREE

PROPOSED IMPROVEMENTS

1	12" DOUBLE SWING DRIVE GATE PER DETAIL "A"
3	12" SINGLE SWING DRIVE GATE PER DETAIL "C"
3	PEDESTRIAN ENTRANCES PER DETAIL "B"
±1003	LINEAL FEET OF FENCING

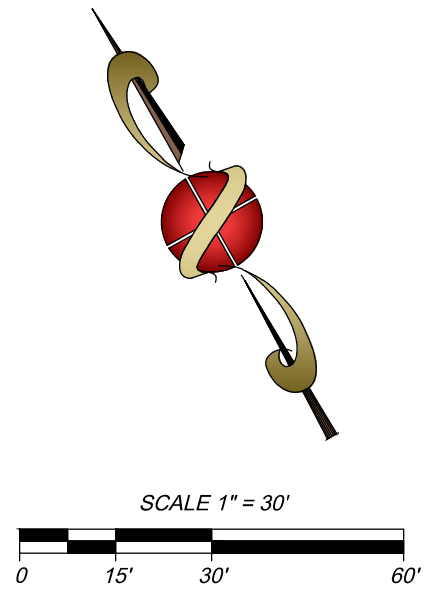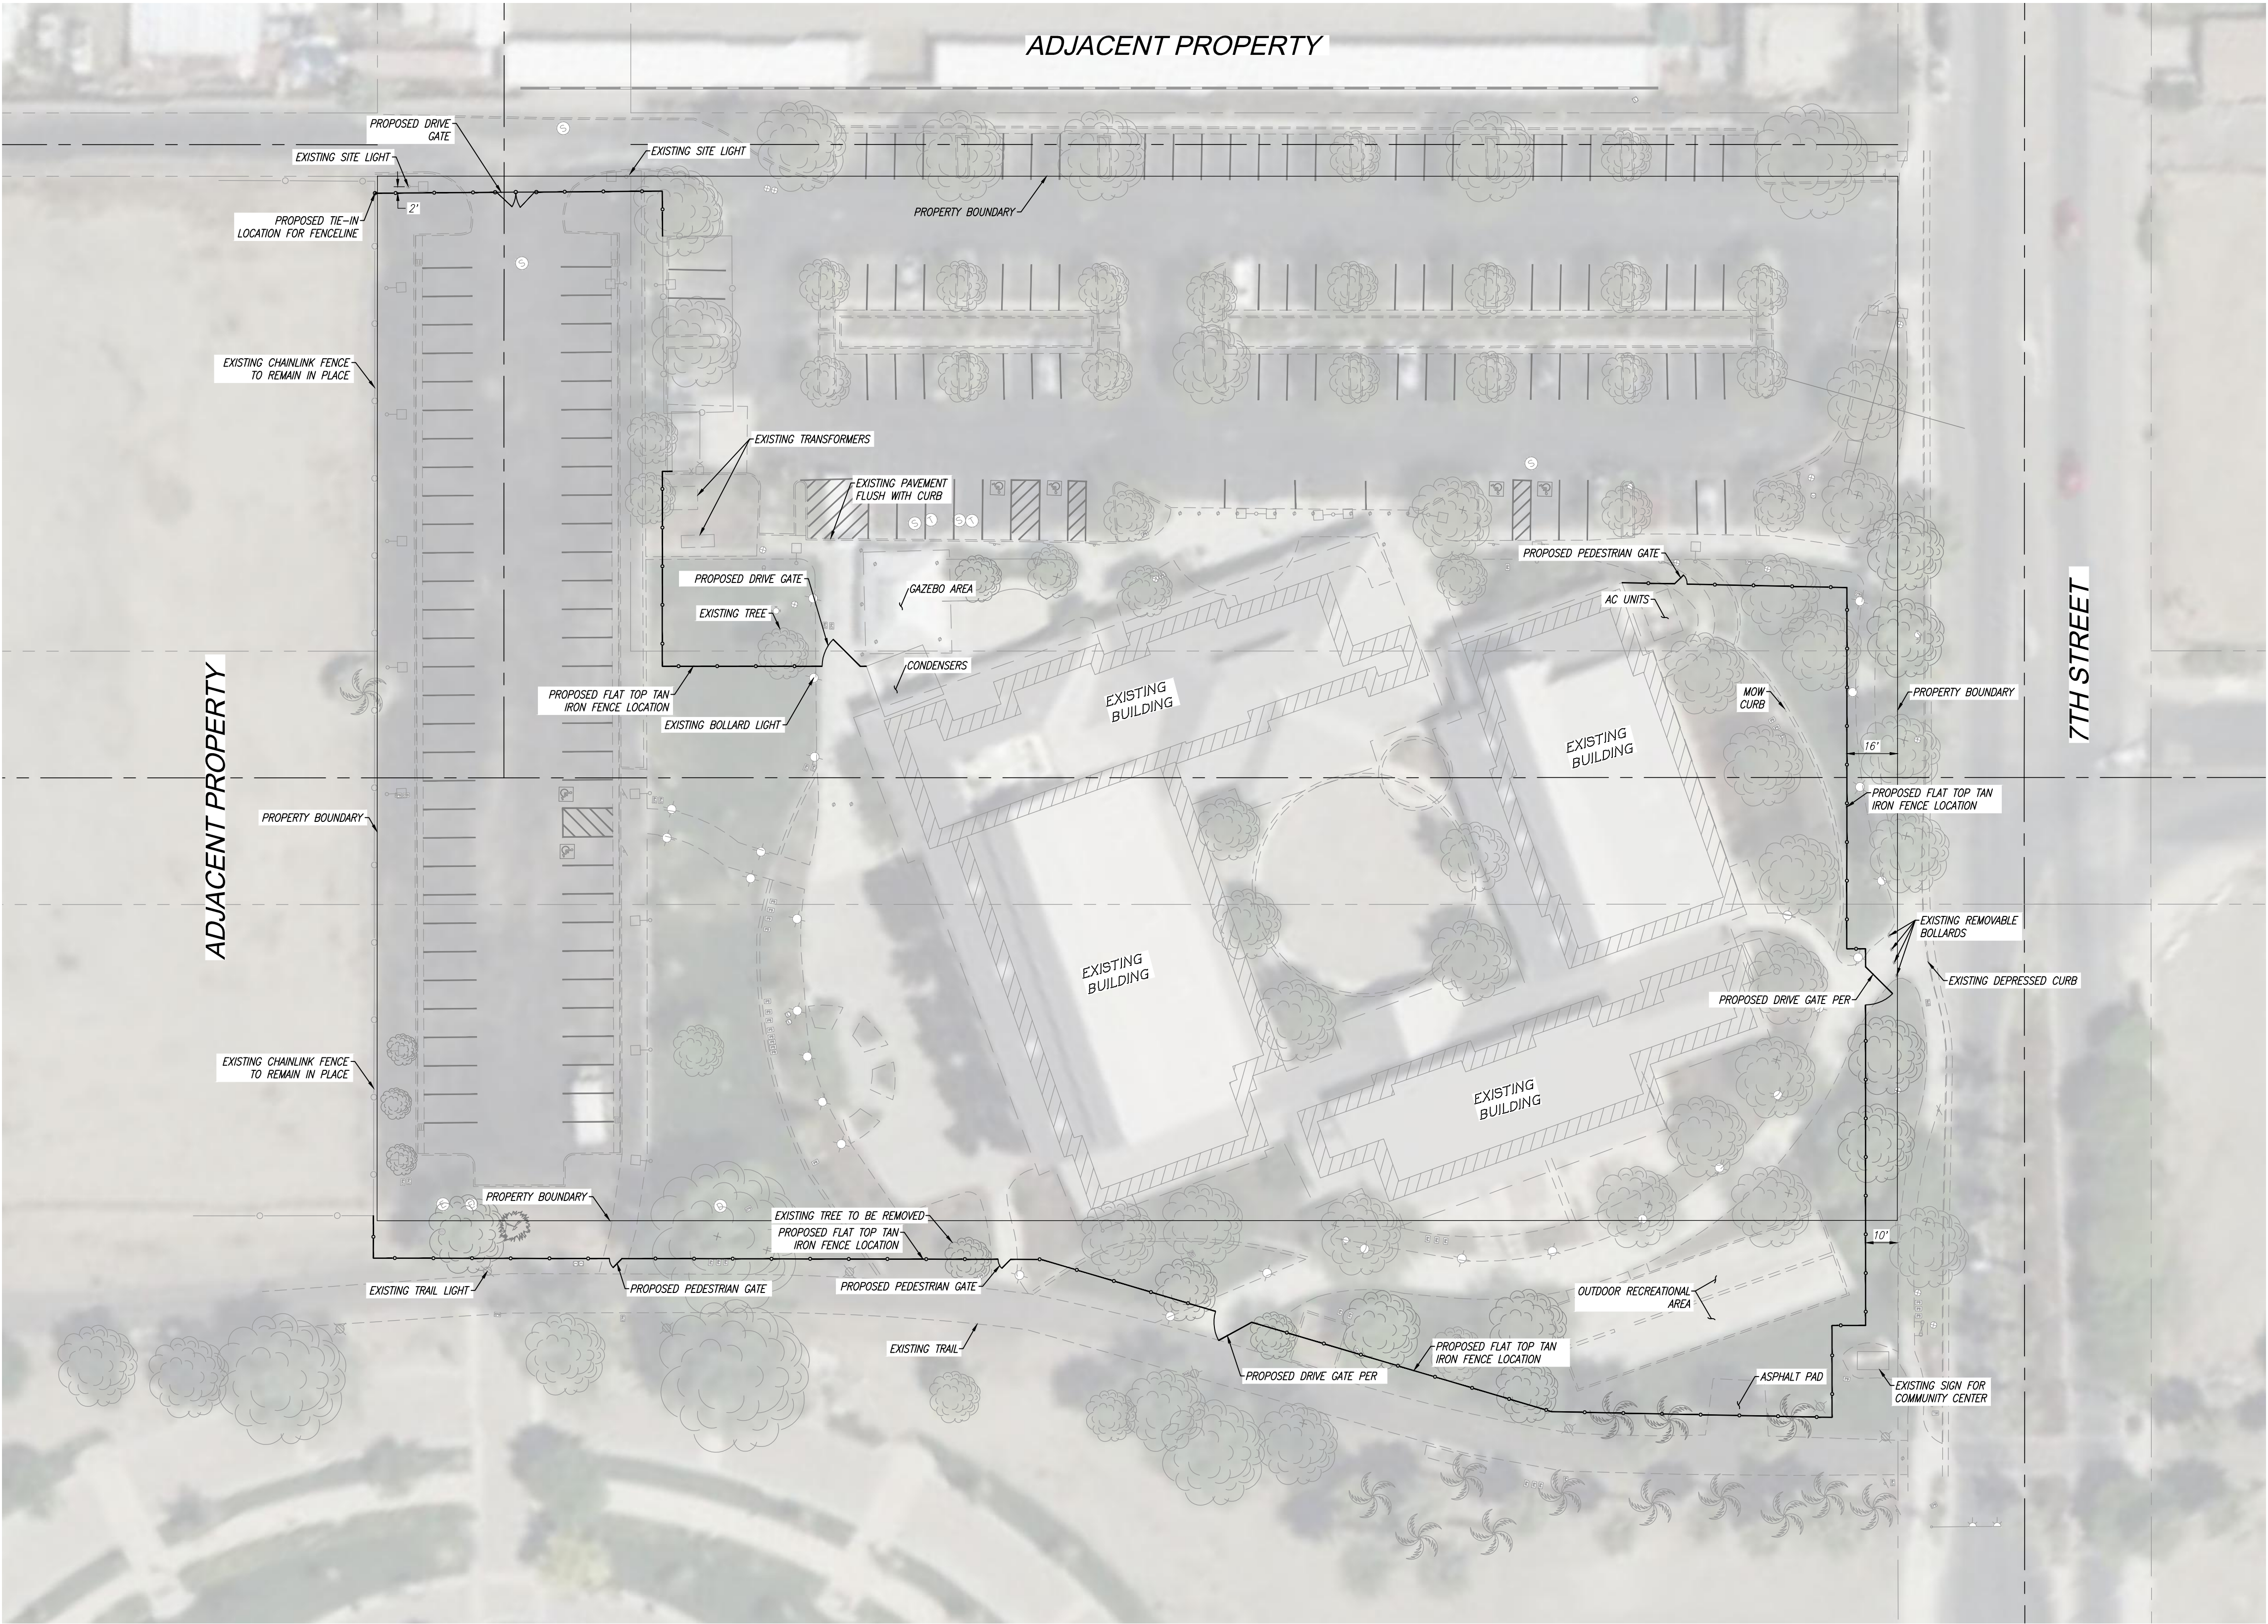

PLANNING • SURVEYING • CIVIL ENGINEERING
1234 O STREET, FRESNO, CALIFORNIA 93721
TEL: 559-449-4500 FAX: 559-449-4515
WWW.PRECISIONENG.NET



PROJECT TITLE: COMMUNITY CENTER

SHEET DESCRIPTION: PROPOSED FENCELINE

CITY OF: LOS BANOS

PREPARED FOR: CITY OF LOS BANOS
520 J STREET
LOS BANOS, CA 93635
(209)827-7000

REVISIONS

DRAWN BY: JAG
CHECKED BY: DY
DATE: 5/21/2024

SHEET NUMBER:
1 OF 1

JOB NUMBER:
19-163.36